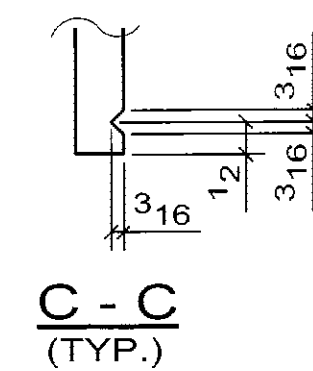
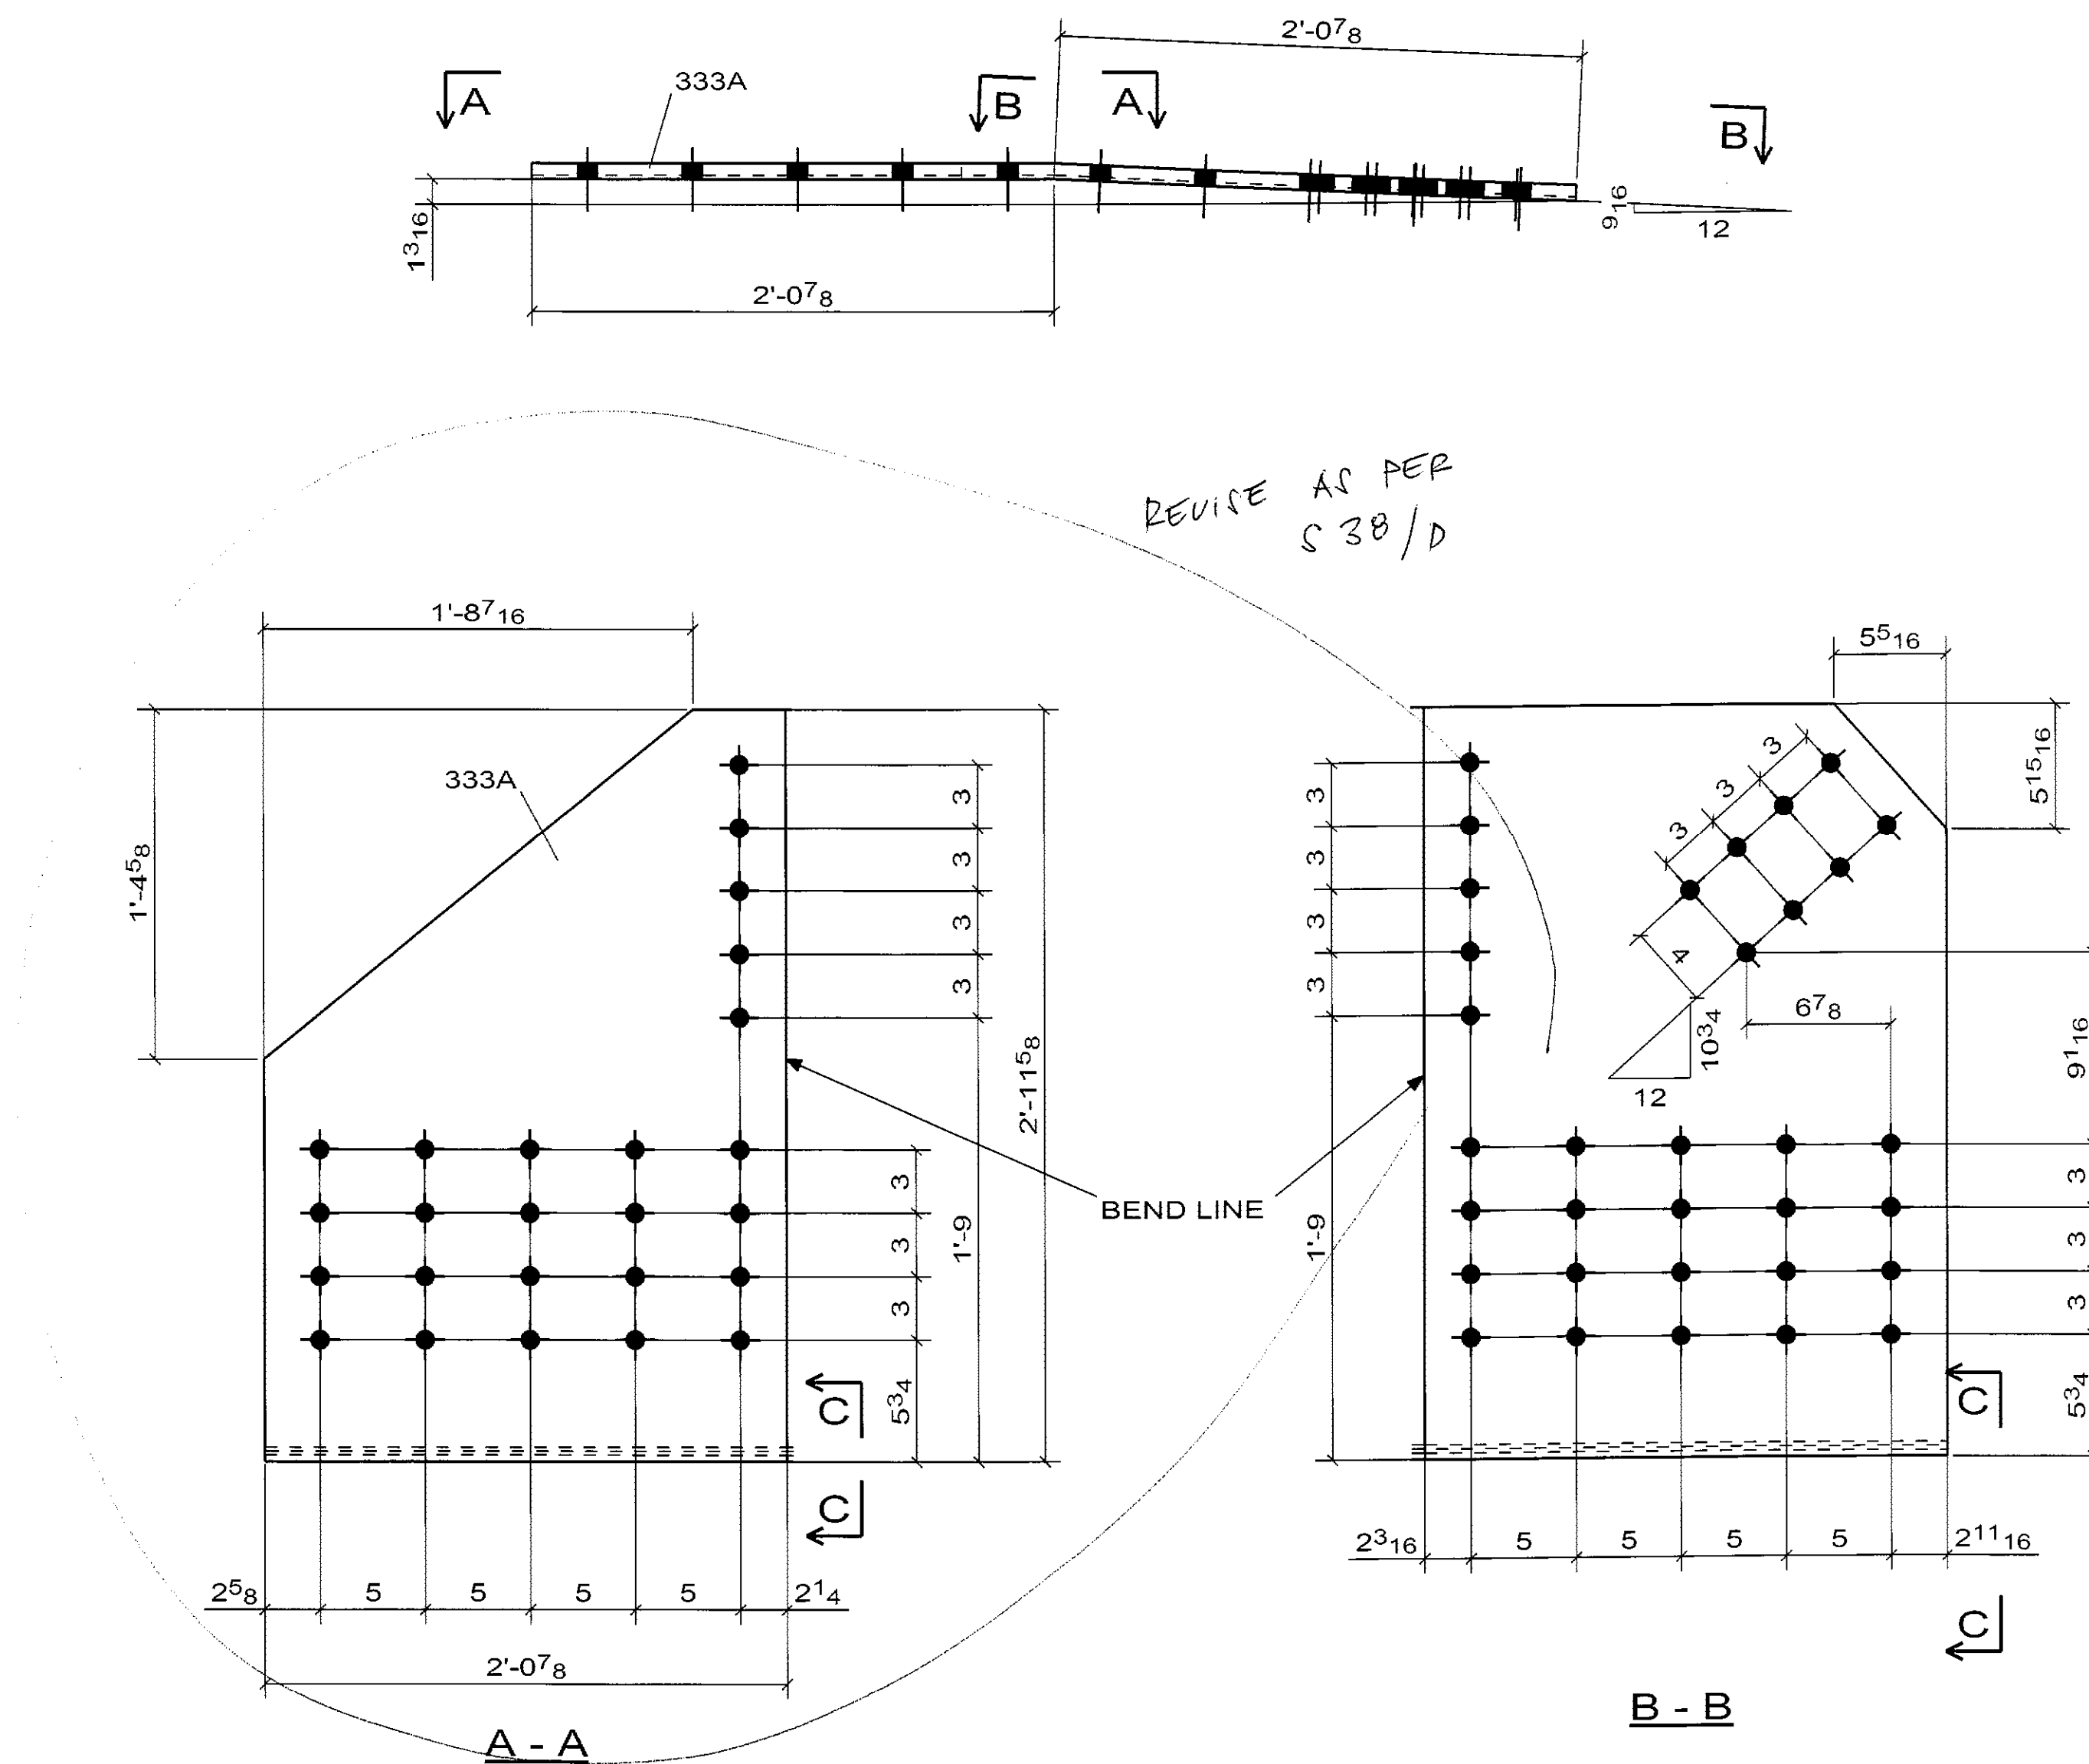


[illegible]

☐ CONFORMS TO DESIGN CONCEPT

☐ CONFORMS TO DESIGN CONCEPT WITH REVISIONS AS SHOWN

☒ NON-CONFORMING-REVISE & RESUBMIT


THIS SHOP DRAWING HAS BEEN REVIEWED FOR GENERAL CONFORMANCE WITH DESIGN CONCEPT ONLY AND DOES NOT RELIEVE THE FABRICATOR/ENDOR OF RESPONSIBILITY FOR CONFORMANCE WITH DESIGN DRAWINGS AND SPECIFICATIONS ALL OF WHICH HAVE PRIORITY OVER THIS SHOP DRAWING.

By AIF DATE 10/13/06


I, IN & ASSOCIATES, INC.

2 - GUSSET_PLATE -333A

WELD NOTE FOR ANY ASSEMBLY REQUIRING TACK WELDS:
- ALL TACK WELDS ARE TO BE MADE IN THE WELD JOINT ONLY

CONTRACTOR NOTE: THIS DRAWING IS BEING SUBMITTED FOR APPROVAL. AS REQUIRED, VERIFY OR SUPPLY ALL QUANTITIES, ALL DIMENSIONS AND INFORMATION, & ALL CONFIGURATIONS.							
PRINT RECORD		OPEN HOLES					
		15/16" OUN					
		WELD		SEP/10/06		FOR APPROVAL	
		BRIDGE WELDING CODE: D1.5		DATE		DESCRIPTION	
NO.		USE		REV		VS	
APPR.		STEEL					
APPR.		BOLTS					
PURCH		SURFACE PRIMP-SP					
FAB		PAINT					
		SEE SPECS					
FAB. OFFICE		REF DRAWING		PROJECT			
		E4, E5		TOLT BRIDGE No 1834A			
Q.A.				THIS DRAWING INCLUDES			
DIST.				FOR			
ERECT.				SNOWHOMISH COUNTY OFFICIAL			
		DRAWN AT		CHK DATE		DWG NUMBER	
		DATE 02/10/2006		DISC 02/10/2006		2707 - 333A	
							

No to SHIP	SHIP MARK	No PIECES	PIECE MARK	DESCRIPTION	LENGTH	UNIT WT.	GRADE	REMARKS
2	341A			GUSSET_PLATE		210		
		2	341A	PL3/4X32 7/16	2'-11 5/8"	210	AASHTO M 270 GR. 50	BEND

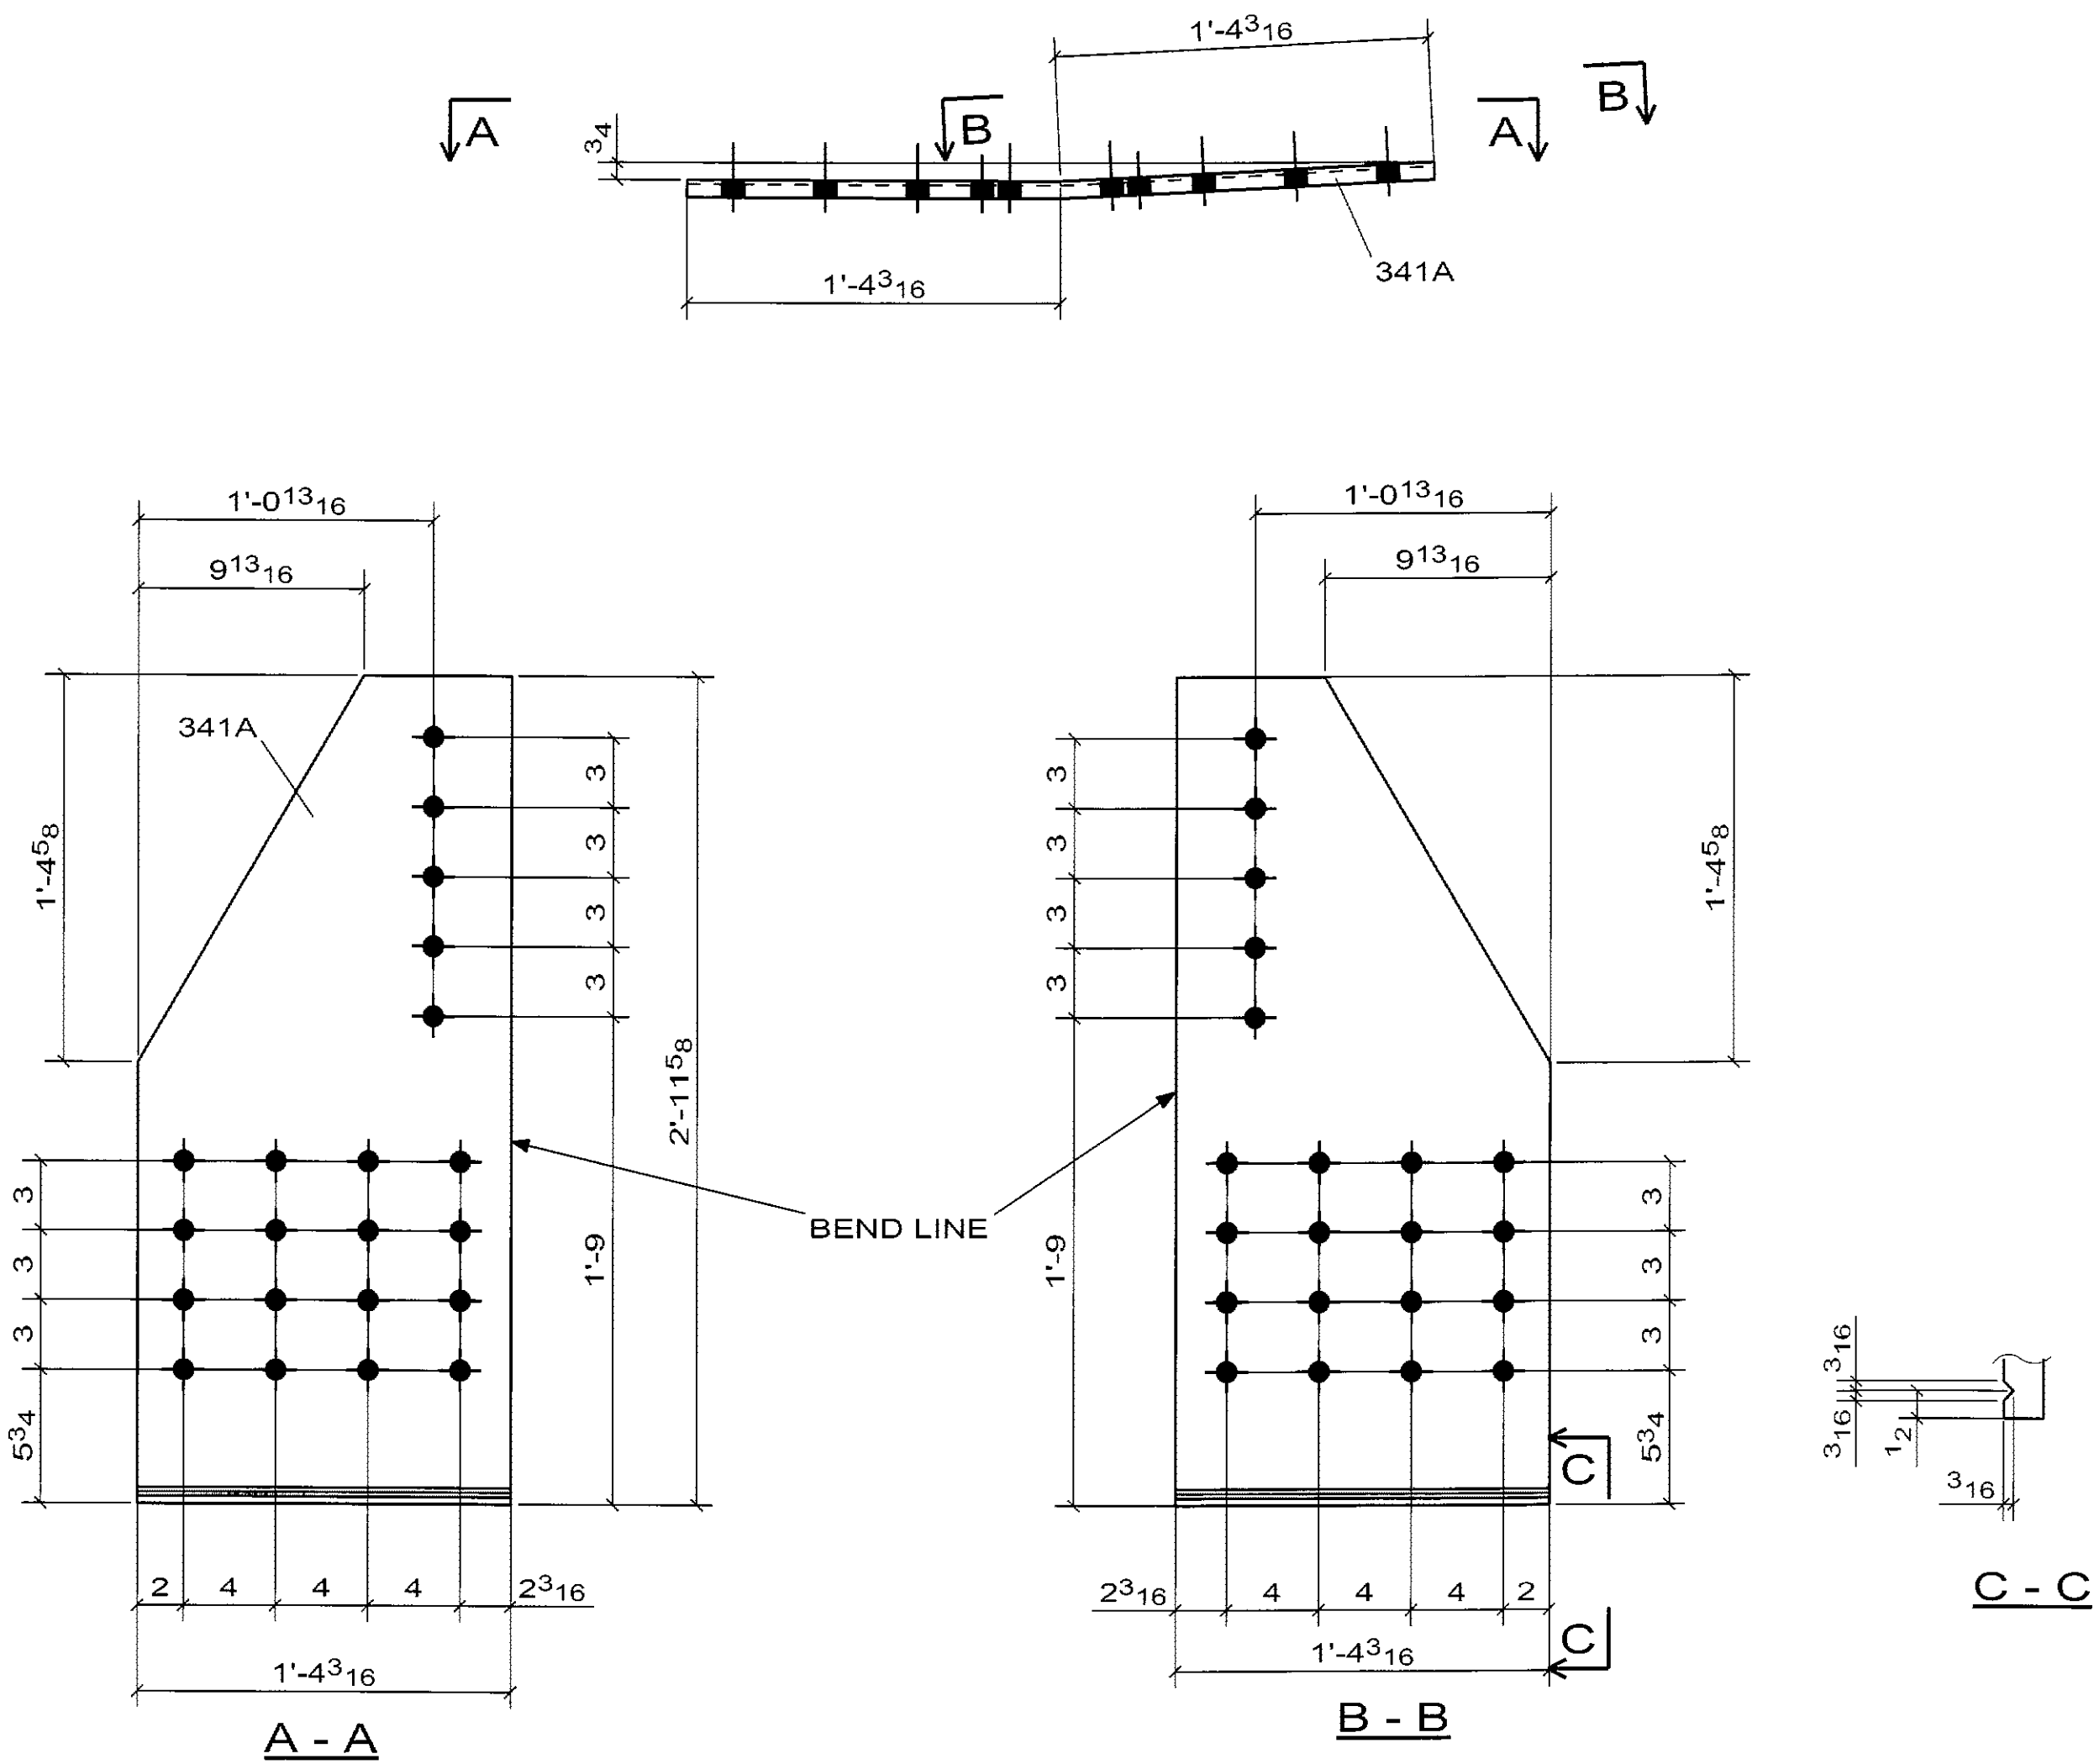

2 - GUSSET_PLATE -341A

☒ CONFORMS TO DESIGN CONCEPT

☐ CONFORMS TO DESIGN CONCEPT WITH REVISIONS AS SHOWN

☐ NON-CONFORMING-REVISE & RESUBMIT

THIS SHOP DRAWING HAS BEEN REVIEWED FOR GENERAL CONFORMANCE WITH DESIGN CONCEPT ONLY AND DOES NOT CONSTITUTE THE FABRICATOR/VENDOR OF RESPONSIBILITY FOR THE ACCURACY OF THE DESIGN DRAWINGS AND SPECIFICATIONS. THE FABRICATOR/VENDOR SHALL BE RESPONSIBLE FOR THE ACCURACY OF THE SHOP DRAWINGS.


By A.F. 10/13/06

I.J.N. & ASSOCIATES, INC.

WELD NOTE FOR ANY ASSEMBLY REQUIRING TACK WELDS:
- ALL TACK WELDS ARE TO BE MADE IN THE WELD JOINT ONLY

CONTRACTOR NOTE: THIS DRAWING IS BEING SUBMITTED FOR APPROVAL AS REQUIRED. VERIFY OR SUPPLY ALL QUANTITIES. ALL DIMENSIONS, ALL INFORMATION, & ALL CONFIGURATIONS.			0 SEP/10/06 FOR APPROVAL			VS.
PRINT RECORD			DESCRIPTION			
NO.	USE	DATE	REV	DATE	DESCRIPTION	
	APPR.					
	APPR.					
	PURCH					
	FAB					
	FAB. OFFICE					
	Q.A.					
	DIST.					
	ERECT.					
OPEN HOLES 15/16 Ø UN			WELD BRIDGE WELDING CODE D1.5			
			AS NOTED			
			SURFACE PREP-SP			
			SEE SPECS			
			E4			
			PROJECT			
			TOLT BRIDGE No 1834A			
			THIS DRAWING INCLUDES			
			FOR			
			SNOWHOMISH COUNTY OFFICIAL			
			DRAWN AT			
			DATE 09/07/2006			
			CHK DSC			
			DATE 09/10/2006			
			DWG NUMBER			
			2707 - 341A			

No to SHIP	SHIP MARK	No. PIECES	PIECE MARK	DESCRIPTION	LENGTH	UNIT WT.	GRADE	REMARKS
2	337A			GUSSET_PLATE		315		
		2	337A	PL3/4X33 5/8	4'-0 15/16"	315	AASHTO M 270 GR. 30	BEND

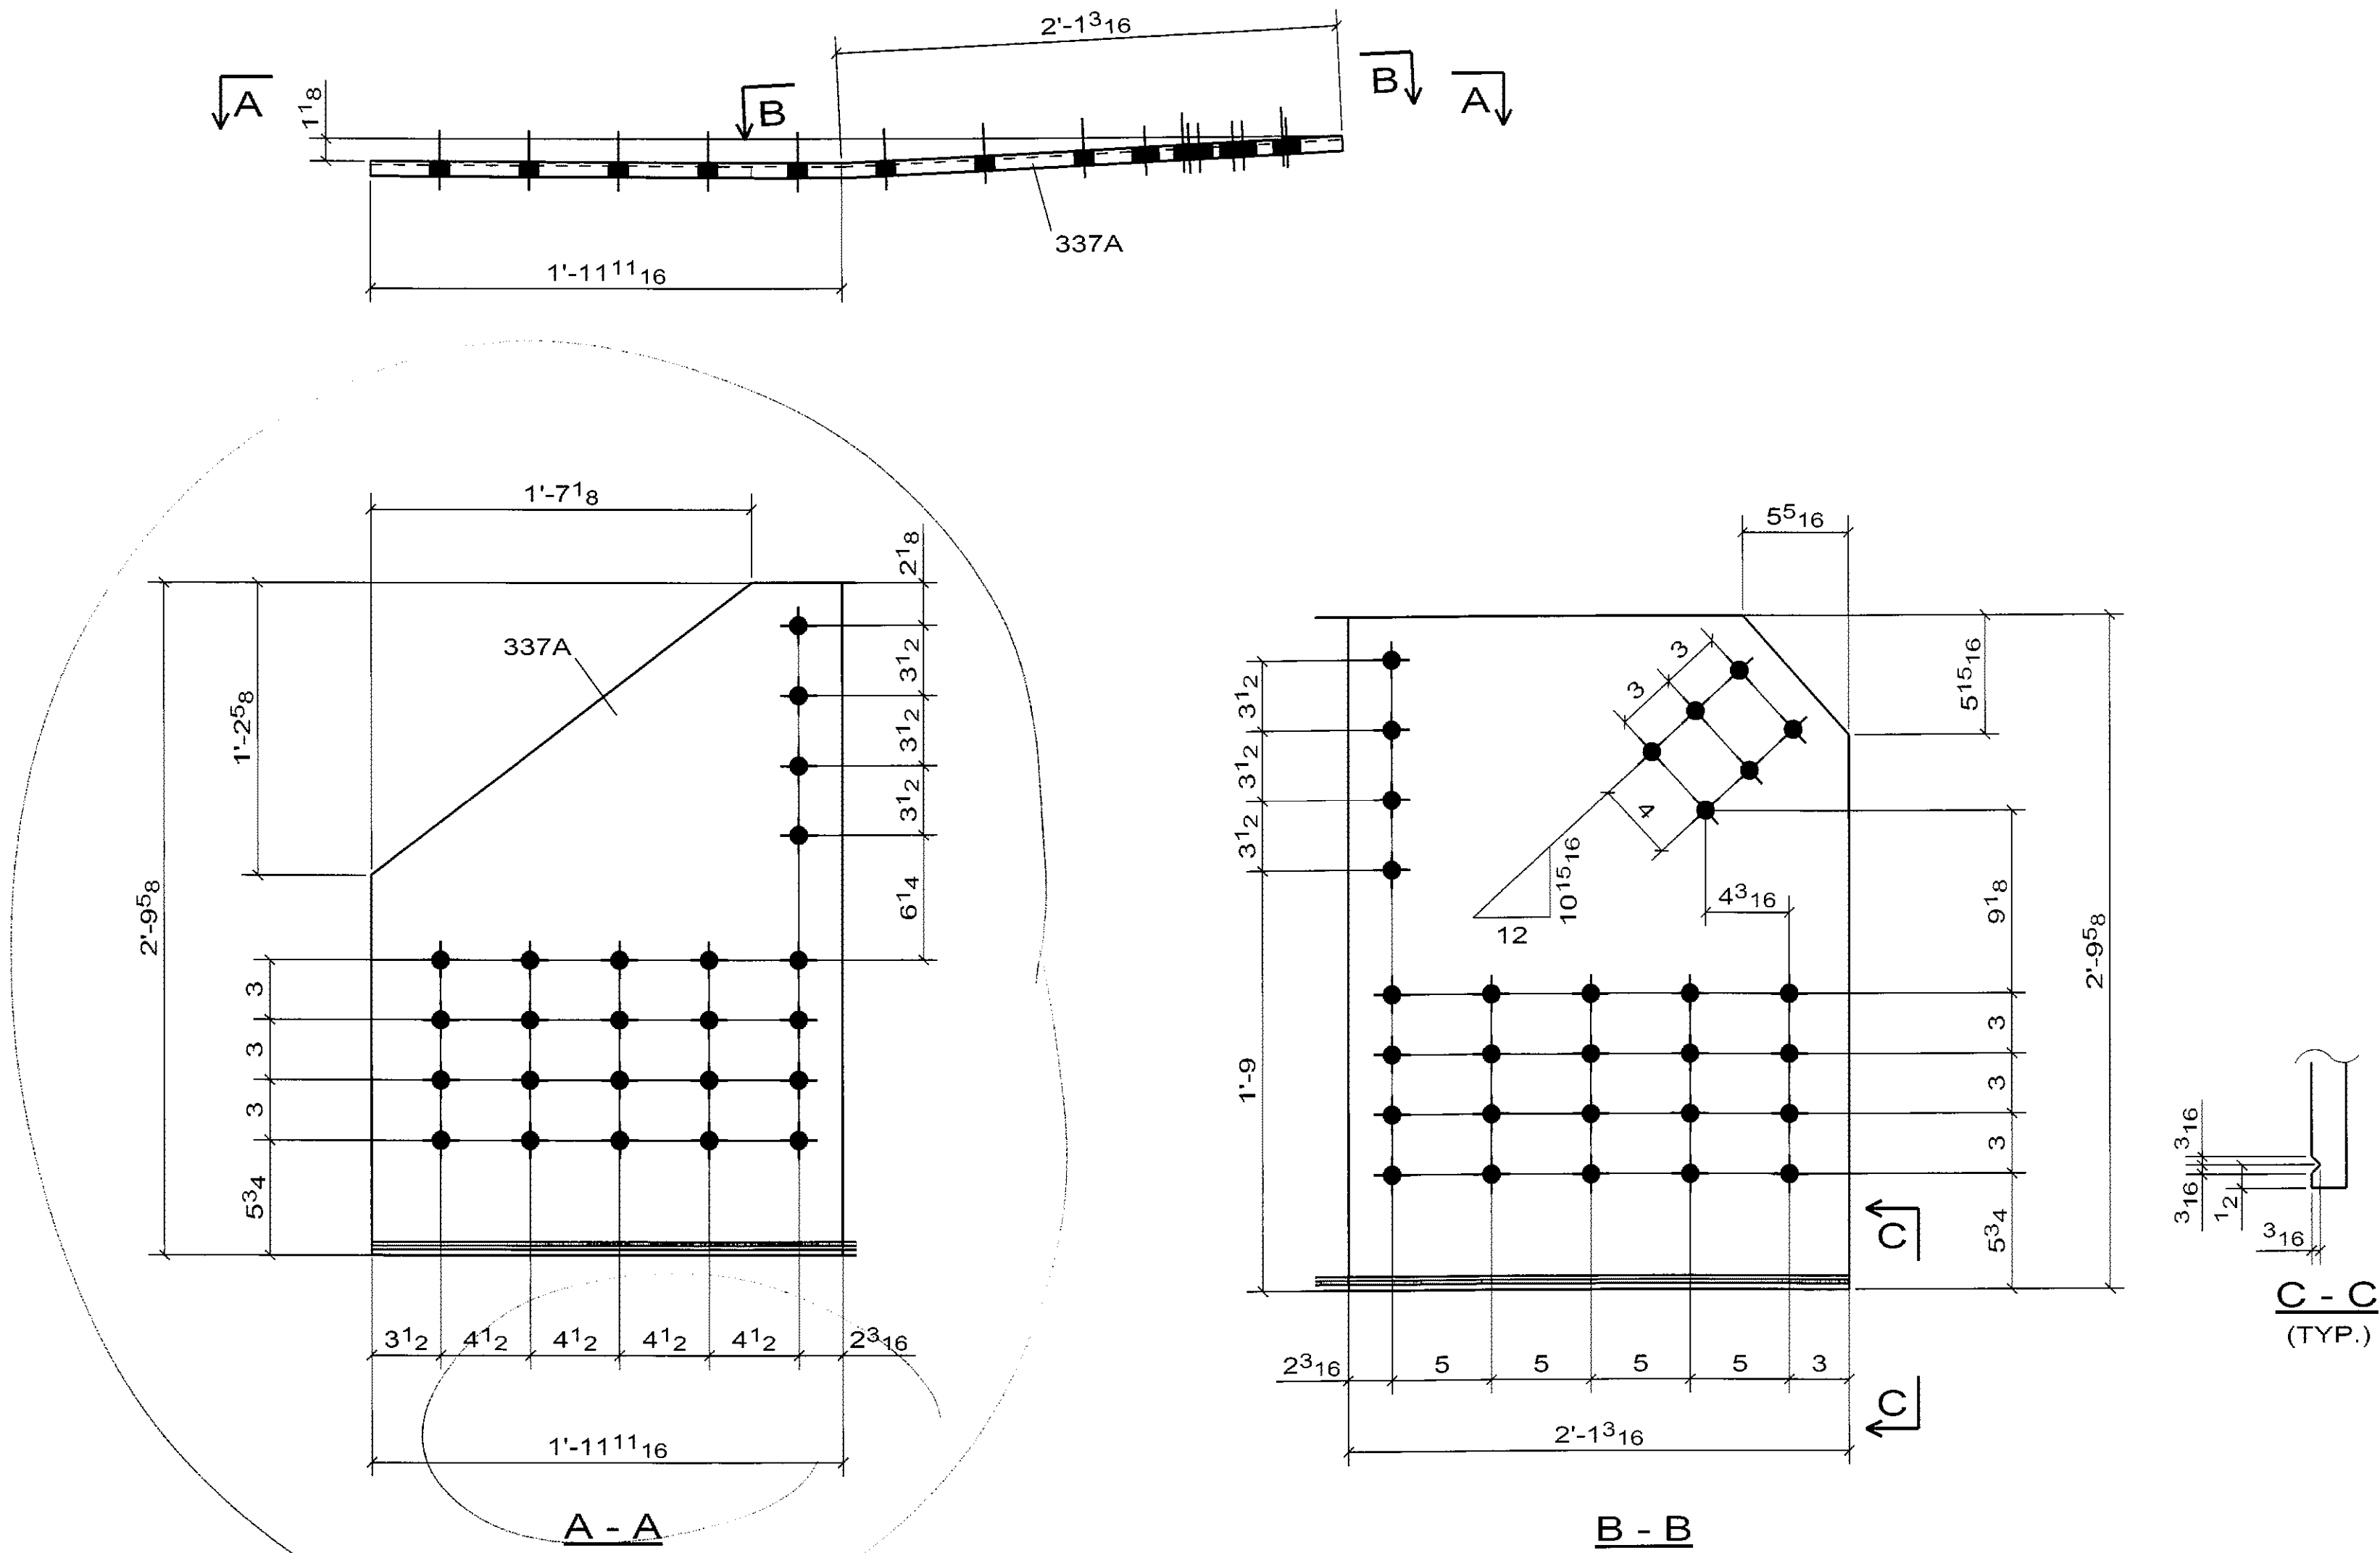

REVISE AS PER
S 40 / A, C


☐ CONFORMS TO DESIGN CONCEPT
☐ CONFORMS TO DESIGN CONCEPT WITH REVISIONS AS SHOWN
☒ NON-CONFORMING-REVISE & RESUBMIT
THIS SHOP DRAWING HAS BEEN REVIEWED FOR GENERAL CONFORMANCE WITH DESIGN CONCEPT ONLY AND DOES NOT RELIEVE THE FABRICATOR/VENDOR OF RESPONSIBILITY FOR CONFORMANCE WITH DESIGN DRAWINGS AND SPECIFICATIONS ALL OF WHICH TAKE PRIORITY OVER THIS SHOP DRAWING.
 By A.F. 10/13/06
I.J.N & ASSOCIATES, INC.

CONTRACTOR NOTE:			
THIS DRAWING IS BEING SUBMITTED FOR APPROVAL AS REQUIRED. VERIFY OR SUPPLY ALL QUANTITIES, ALL DIMENSIONS, ALL INFORMATION, & ALL CONFIGURATIONS.			
PRINT RECORD		OPEN HOLES	
NO.	USE	DATE	15/16 Ø 1/4"
APPR.	STEEL	DATE	BRIDGE WELDING CODE: D1.5
APPR.	BOLTS	DATE	AS NOTED
PURCH.	SURFACE PREP-SP	DATE	
FAB.	PAINT	DATE	SEE SPECS
FAB. OFFICE	REF. DRAWING	DATE	E4, E5
Q.A.		DATE	
DIST.		DATE	
ERECT.		DATE	

REV	DATE	DESCRIPTION	VS.
0	SEP/10/06	FOR APPROVAL	
RAINIER WELDING 19020 NE 84TH STREET - REDMOND, WA 98053 (425) 868-1300 FAX (425) 868-8872 STEEL AND ALUMINUM FABRICATING			
PROJECT TOLT BRIDGE No 1834A			
THIS DRAWING INCLUDES			
FOR SNOHOMISH COUNTY OFFICIAL			
DRAWN AT	CHK DSC	DWG NUMBER	
DATE 09/08/2006	DATE 09/10/2006	2707	- 337A

WELD NOTE FOR ANY ASSEMBLY REQUIRING TACK WELDS:
- ALL TACK WELDS ARE TO BE MADE IN THE WELD JOINT ONLY

No to SHIP	SHIP MARK	No PIECES	PIECE MARK	DESCRIPTION	LENGTH	UNIT WT.	GRADE	REMARKS
2	336A			GUSSET_PLATE		315		
		2	336A	PL3/4X33 5/8	4'-0 7/8"	315	AASHTO M 270 GR. 50	BEND

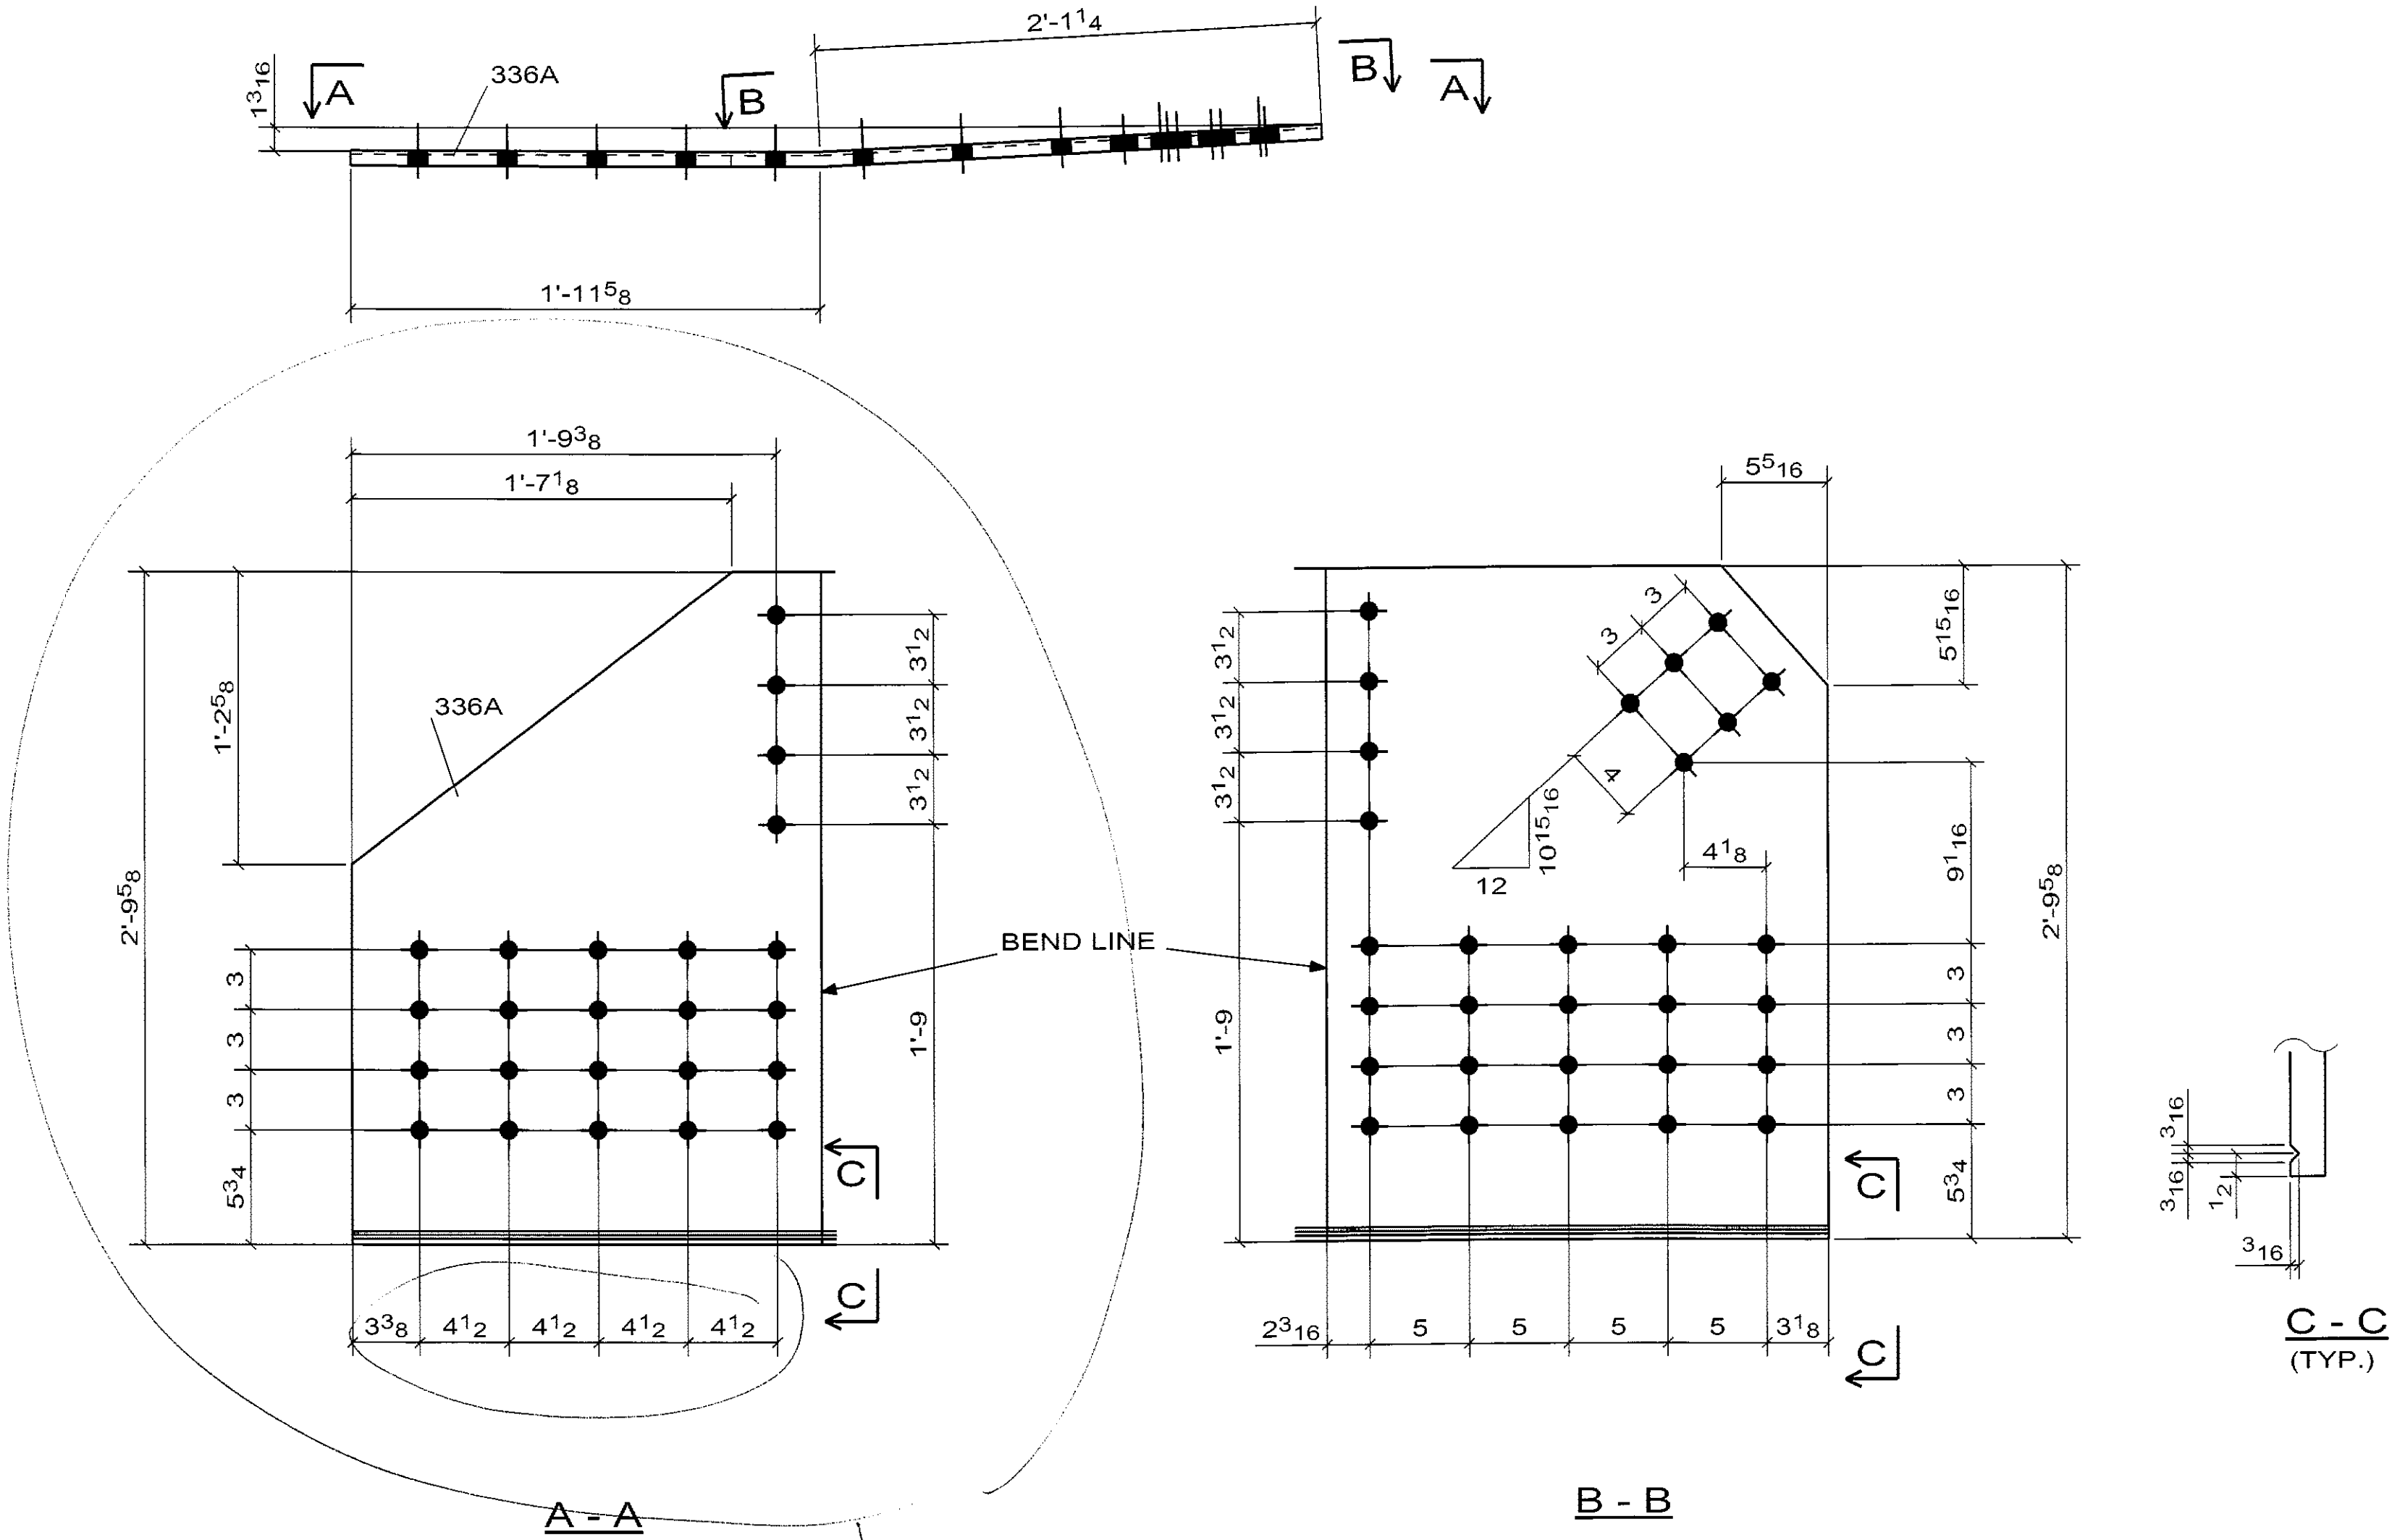

REVISE AS PER
S 39/AIC

2 - GUSSET_PLATE -336A

WELD NOTE FOR ANY ASSEMBLY REQUIRING TACK WELDS:
- ALL TACK WELDS ARE TO BE MADE IN THE WELD JOINT ONLY

☐ CONFORMS TO DESIGN CONCEPT

☐ CONFORMS TO DESIGN CONCEPT WITH REVISIONS AS SHOWN

☒ NON-CONFORMING-REVISE & RESUBMIT

THIS SHOP DRAWING HAS BEEN REVIEWED FOR GENERAL CONFORMANCE WITH DESIGN CONCEPT ONLY AND DOES NOT RELIEVE THE FABRICATOR/VENDOR OF RESPONSIBILITY FOR CONFORMANCE WITH DESIGN DRAWINGS AND SPECIFICATIONS ALL OF WHICH HAVE PRIORITY OVER THIS SHOP DRAWING.

By A.F. 10/18/06

I.J.N & ASSOCIATES, INC.

CONTRACTOR NOTE:
THIS DRAWING IS BEING SUBMITTED FOR APPROVAL AS REQUIRED. VERIFY OR SUPPLY ALL QUANTITIES, ALL DIMENSIONS, ALL INFORMATION, & ALL CONSIDERATIONS.

PRINT RECORD

NO.	USE	DATE	FIELD	OPEN HOLES
	APPR.		BRIDGE WELDING CODE: D1.5	15/16 Ø U/N
	APPR.		STEEL	AS NOTED
	PURCH.		BOLTS	
	FAB.		SURFACE PREP-SP	
	FAB. OFFICE		PAINT	SEE SPECS
	Q.A.		REF DRAWING	E4, E5
	DIST.			
	ERECT.			

REV	DATE	DESCRIPTION
0	SEP/10/06	FOR APPROVAL

RAINIER WELDING

19020 NE 84TH STREET - REDMOND, WA 98053
(425) 868-1300 FAX (425) 868-8672

STEEL AND ALUMINUM FABRICATING

PROJECT

TOLT BRIDGE No 1834A

THIS DRAWING INCLUDES

FOR SNOHOMISH COUNTY OFFICIAL



DRAWN AT DATE 09/07/2006

CHK DSC DATE 09/10/2006

DWG NUMBER 2707

- 336A

No to SHIP	SHIP MARK	No PIECES	PIECE MARK	DESCRIPTION	LENGTH	UNIT WT.	GRADE	REMARKS
2	335A			GUSSET_PLATE		315		
		2	335A	PL 3/4 X 33 5/8	4'-0 7/8"	315	AASHTO M 270 GR. B	BEND

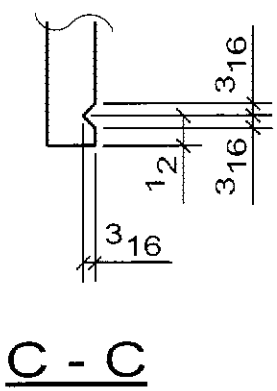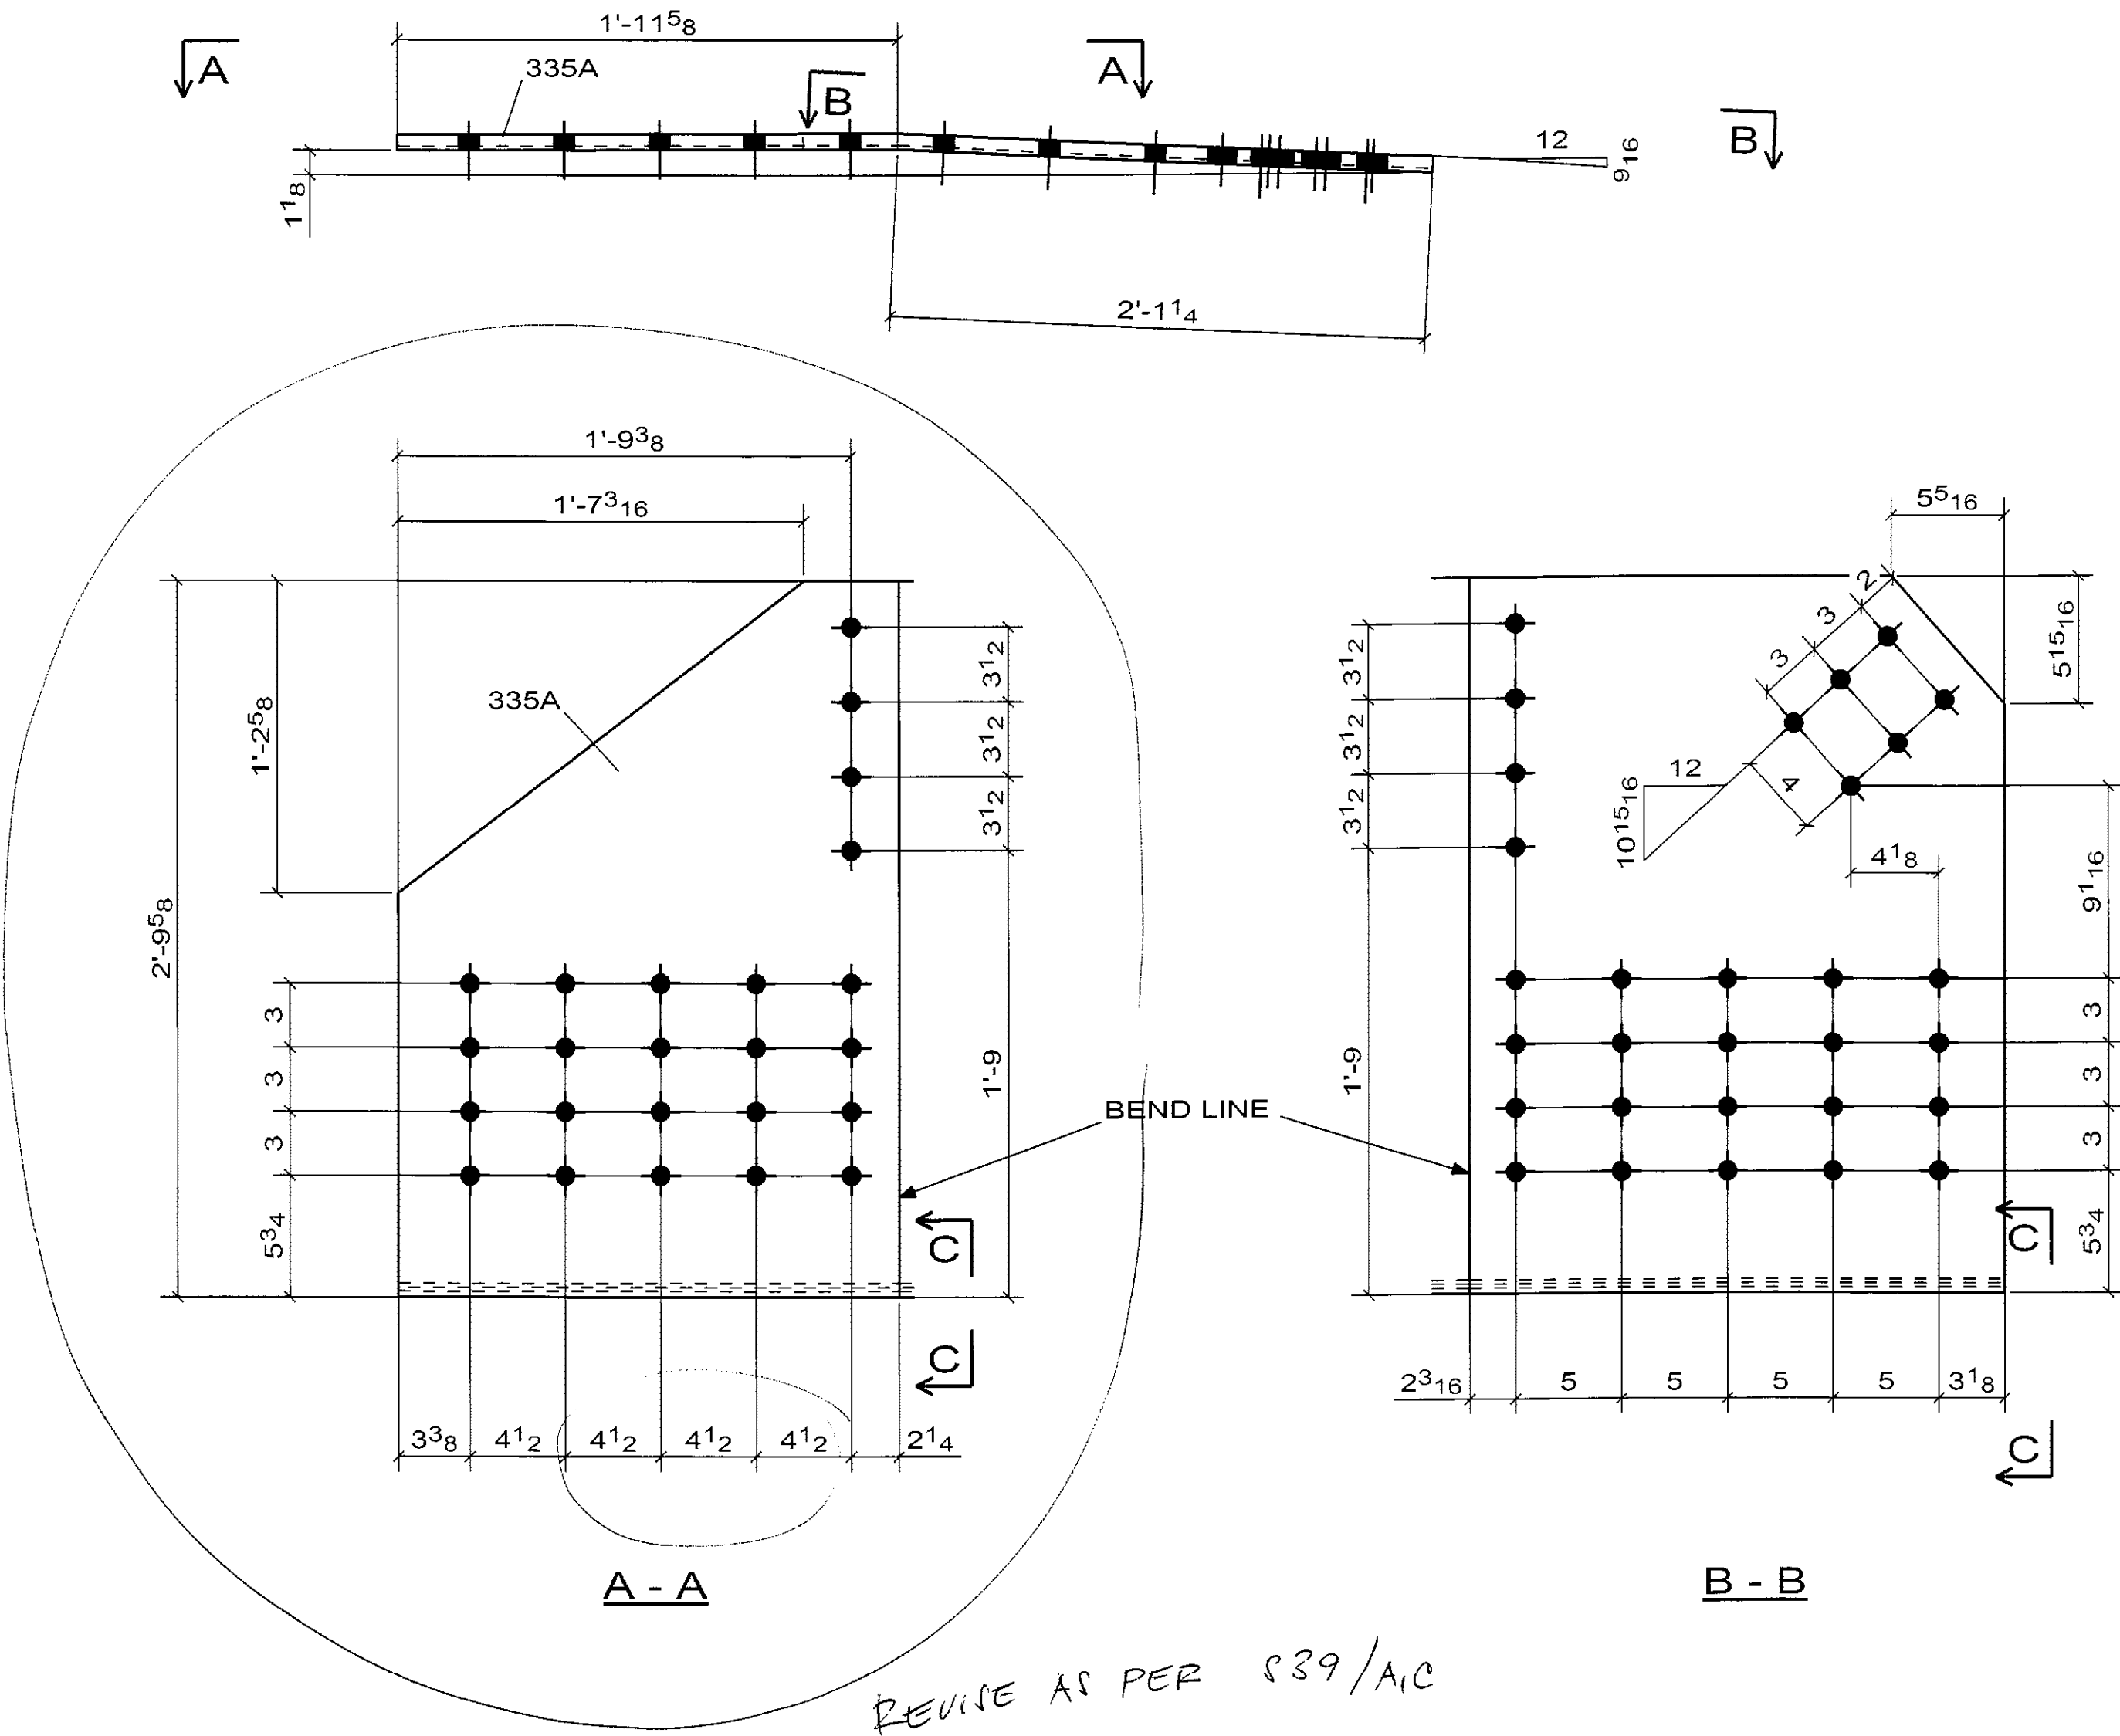


☐ CONFORMS TO DESIGN CONCEPT
☐ CONFORMS TO DESIGN CONCEPT WITH REVISIONS AS SHOWN
☒ NON-CONFORMING-REVISE & RESUBMIT
THIS SHOP DRAWING HAS BEEN REVIEWED FOR GENERAL CONFORMANCE WITH DESIGN CONCEPT ONLY AND DOES NOT RELIEVE THE FABRICATOR/VENDOR OF RESPONSIBILITY FOR CONFORMANCE WITH DESIGN DRAWINGS AND SPECIFICATIONS ALL OF WHICH HAVE PRIORITY OVER THIS SHOP DRAWING.
 By A.L.F. 10/13/06
I.J.N & ASSOCIATES, INC.

CONTRACTOR NOTE: <small>THIS DRAWING IS BEING SUBMITTED FOR APPROVAL AS REQUIRED. VERIFY OR SUPPLY ALL QUANTITIES. ALL DIMENSIONS, ALL INFORMATION, & ALL CONFIGURATIONS.</small>				PRINT RECORD <small>NO. USE DATE WELD BRIDGE WELDING CODE D1.5</small>				<small>0 SEP/10/06 FOR APPROVAL</small>				<small>VS</small>			
<small>APPR. STEEL AS NOTED</small>				<small>APPR. BOLTS</small>				<small>APPR. SURFACE PREP-SP</small>				<small>FAB. PAINT SEE SPECS</small>			
<small>FAB. OFFICE REF DRAWING E4, E5</small>				<small>G.A.</small>				<small>DIST.</small>				<small>ERECT.</small>			
<small>PROJECT TOLT BRIDGE No 1834A</small>				<small>FOR SNOHOMISH COUNTY OFFICIAL</small>				<small>DATE 09/07/2006</small>				<small>DATE 09/10/2006</small>			
<small>THIS DRAWING INCLUDES</small>				<small>DATE 09/07/2006</small>				<small>DATE 09/10/2006</small>				<small>2707 - 335A</small>			

2 - GUSSET_PLATE -335A

WELD NOTE FOR ANY ASSEMBLY REQUIRING TACK WELDS:
 - ALL TACK WELDS ARE TO BE MADE IN THE WELD JOINT ONLY

No to SHIP	SHIP MARK	No PIECES	PIECE MARK	DESCRIPTION	LENGTH	UNIT WT.	GRADE	REMARKS
2	334A			GUSSET_PLATE		336		
		2	334A	PL3/4X35 5/8	4'-1 11/16"	336	AASHTO M270 GR. 30	BEND

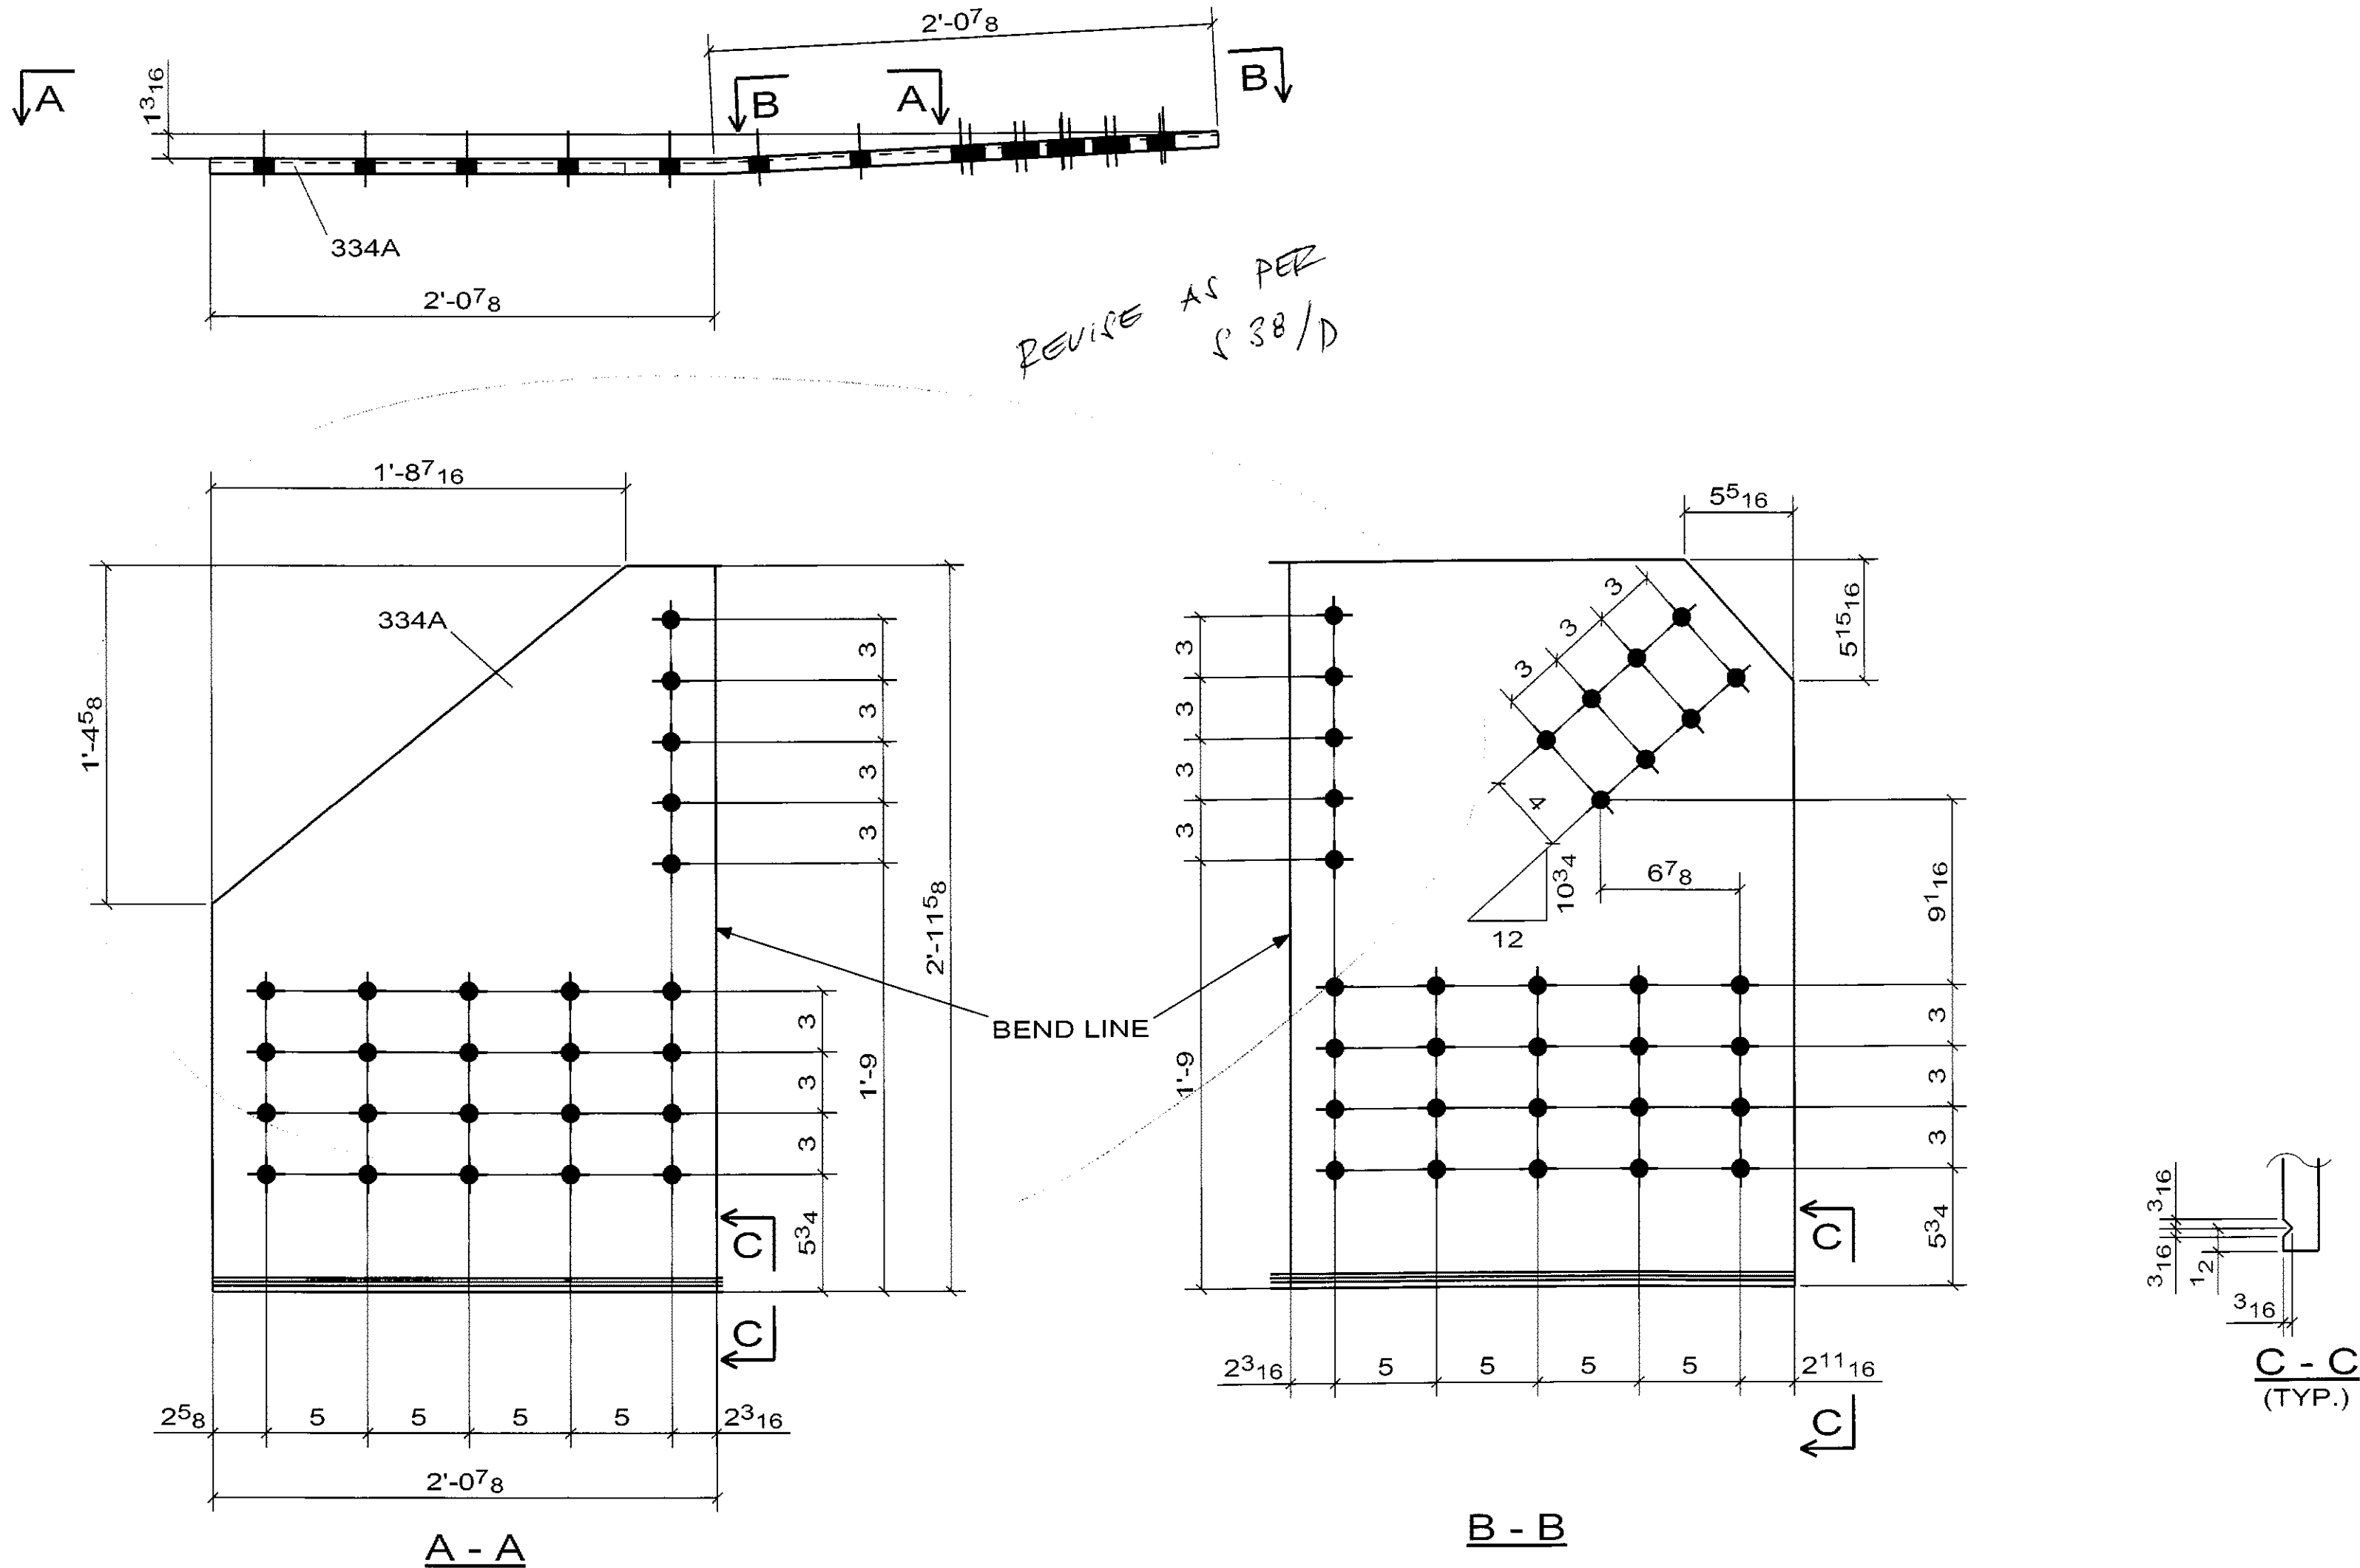

☐ CONFORMS TO DESIGN CONCEPT
 ☐ CONFORMS TO DESIGN CONCEPT WITH REVISIONS AS SHOWN
 ☒ NON-CONFORMING-REVISE & RESUBMIT

THIS SHOP DRAWING HAS BEEN REVIEWED FOR GENERAL CONFORMANCE WITH DESIGN CONCEPT ONLY AND DOES NOT RELIEVE THE FABRICATOR/VENDOR OF RESPONSIBILITY FOR CONFORMANCE WITH DESIGN DRAWINGS AND SPECIFICATIONS ALL OF WHICH TAKE PRECEDENCE OVER THIS SHOP DRAWING.

By A.F. 10/13/06
I.I.N & ASSOCIATES, INC.

CONTRACTOR NOTE:				THIS DRAWING IS BEING SUBMITTED FOR APPROVAL AS REQUIRED. VERIFY OR SUPPLY ALL QUANTITIES, ALL DIMENSIONS, ALL INFORMATION, & ALL CONFIGURATIONS.			
PRINT RECORD				OPEN HOUSE			
				1516 Ø UIN			
				0	SEP10/06	FOR APPROVAL	VS
				REV	DATE	DESCRIPTION	
NO.	USE	DATE	WELD	BRIDGE WELDING CODE: D1.5			
	APPR.		STEEL	AS NOTED			
	APPR.		BOLTS				
	PURCH		SURFACE PREP-SP				
	FAB		PAINT	SEE SPECS			
FAB OFFICE			REF DRAWING	E4, E5			
Q.A.							
DIST.							
ERECT.							
				PROJECT			
				TOLT BRIDGE NO 1834A			
				THIS DRAWING INCLUDES			
				FOR			
				SNOHOMISH COUNTY OFFICIAL			
DRAWN AT				CHK	DSC	DWG NUMBER	
DATE				DATE	DATE	2707 - 334A	
09/07/2006				09/10/2006	09/10/2006		

WELD NOTE FOR ANY ASSEMBLY REQUIRING TACK WELDS:
 - ALL TACK WELDS ARE TO BE MADE IN THE WELD JOINT ONLY